




F.1 PARTITIONS: ASI GLOBAL PARTITIONS:
FOLKSTONE GRAY 9400 SOLID PLASTIC

F.2 INTERIOR CONCRETE FLOOR:
SW FastTop 12SL Self-Leveling Urethane Slurry System
APPLICATION:
Primer 3477
Slurry @ $\frac{3}{8}$ " (Color Dark Gray) Broadcast Standard Dry
Silica Sand 20-40 mesh cts 480, 5035, 5310-8
Seal Coat 4090TC, 5095
TOP COAT: 1ct GP 3746, 1-2 cts GP 4850

F.3 INTERIOR FLOOR BASE: SW EPOXY COVE BASE SYSTEM
SW GENERAL POLYMERS 3561
APPLICATION: Primer 3561V
Binder Resin 3561V
Grout Coat 3745
Seal Coat 3745

- (F.4)** INTERIOR WOOD FRAMED WALL W/ DensArmor Plus
Fireguard 5% GYPSUM PANELS
(Smooth finish at joints or skim coat joint compound
over entire surface of panels to reduce highlighting)
1ct. SW PRO MAR 200 ZERO VOC PRIMER
2cts. SW PRO-IND. PRE-CATALYZED EPOXY GLOSS
*COLOR- SW0055 LIGHT FRENCH GRAY
- (F.5)** INTERIOR CONCRETE BLOCK WALL:
2cts. SW PRO-IND. PRE-CATALYZED EPOXY SEMI-GLOSS
*COLOR- SW0055 LIGHT FRENCH GRAY
- (F.6)** EXTERIOR CONCRETE BLOCK WALL:
1ct. SW LOXON CONCRETE MASONRY PRIMER SEALER
2cts. SW PRO-INDUSTRIAL ACRYLIC SEMI GLOSS
*COLOR-SW2850 CHELSEA GREY
- (F.7)** CEILING W/ DensArmor Plus Fireguard 5% GYPSUM PANELS
1ct. SW PRO-IND. PRO-CRYL PRIMER.
2cts. SW PRO-IND ACRYLIC PAINT (EIDER WHITE INTERIOR
SEMI-GLOSS SW7104 MILDEW-RESISTANT)

- 1 ADA COMPLIANT WATER CLOSET; METCRAFT
 - ELONGATED BOWL
 - HEAVY DUTY HIGH POLISHED INTEGRAL SEAT, NO COVER; TOILET SEAT.
 - SLOAN SENSOR FLUSHOMETER, SLOAN 8111-1.28 GPF
- 2 ADA COMPLIANT URINAL; METCRAFT
 - HEAVY DUTY STAINLESS STEEL
 - SLOAN G2 SENSOR FLUSHOMETER, G2 8186-05 GPF
- 3 ADA COMPLIANT LAVATORY; METCRAFT
 - RECTANGULAR BASIN
 - TOUCHLESS FAUCET; Z6950-XL-S; 0.5 gal/min AT 60psi
- 4 HIGH SECURITY MIRROR: METCRAFT - A752
- 5 JANITOR SINK: METCRAFT MOP SINK 6390-2
 - 12" HIGH STAINLESS STEEL WALL SHIELD
 - FAUCET: ZURN Z842H1-XL
- 6 WATER FOUNTAIN/BOTTLE FILLING/ PET STATION: ELKAY MODEL LK4420BF1UDBFK FINISH EVERGREEN (EVG)
- 7 ADA COMPLIANT HAND DRYER: WOLD DRYER VERDE[®]
 - AUTOMATIC SURFACE MOUNTED
 - STAINLESS STEEL
- 8 TISSUE DISPENSER: METCRAFT: Item# A723-1
 - STAINLESS STEEL
 - DUAL ROLL HOLDER
- 9 GRAB BARS: METCRAFT:
 - a. Item# A551 36" LONG
 - b. Item# A552 42" LONG
- 10 SEAT COVER DISPENSER: ULINE Item# H-1592 CHROME SEAT COVER.
- 11 SANITARY NAPKIN RECEPTACLE: ULINE Item# H-3454 - STAINLESS STEEL
- 12 FOAMING SOAP AUTO DISPENSER: ULINE Item# H-3415
- 13 CHANGING TABLE: KOALA KARE Item# KB200-01SS GREY HORIZONTAL WALL MOUNTED BABY CHANGING TABLE
- 14 OUTLET LOCKING COVER: LEGRAND WP26L
- 15 EXIT SIGN W/ EMERGENCY LIGHTS ULINE H-6509 RED
- 16 ELECTRIC TANKLESS WATER HEATER: AO Smith C2VA-120E UEF= 0.84

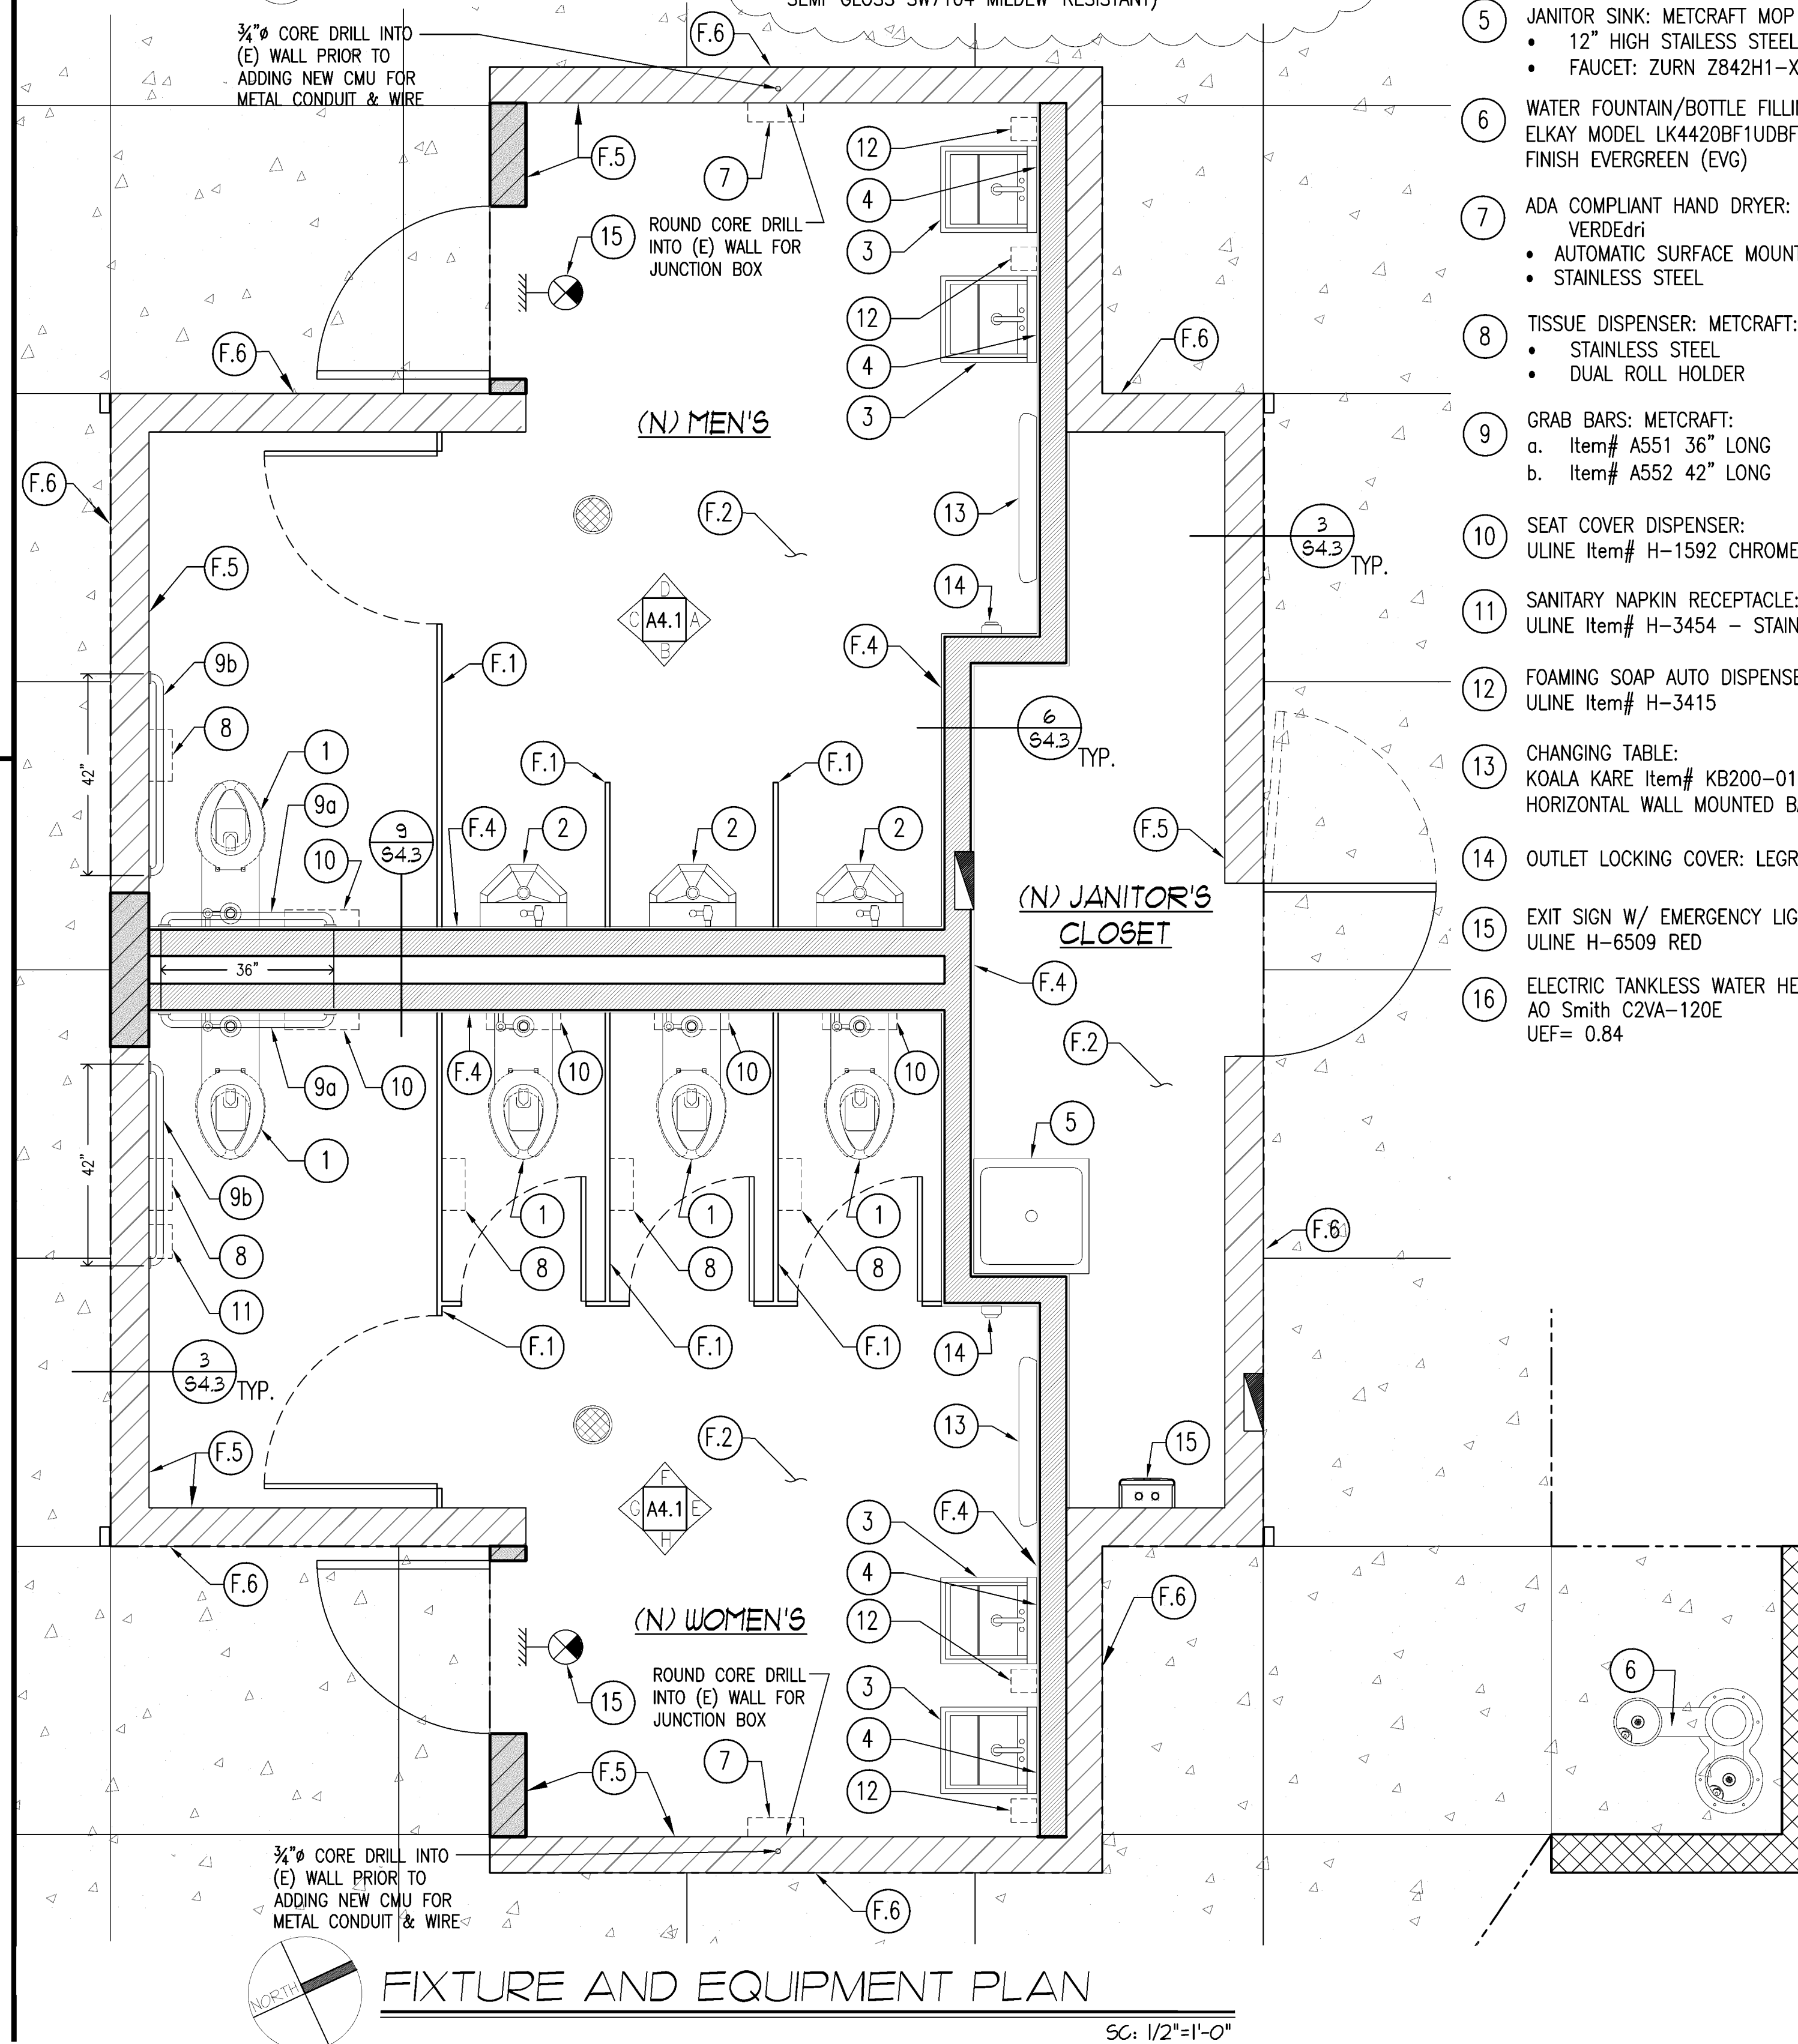

| | | | | | |
|-------------|--------------|---|---|-----------------------|---------|
| | SHEET TITLE: | PROJECT TITLE: | | | |
| JOB No. | CCE-19-10 | | | | |
| DATE: | 9/2/2022 | | | | |
| SCALE: | AS NOTED | | | | |
| DRAWN BY: | VRA | | | | |
| SHEET No.: | A4.1 | | | | |
| # OF SHEETS | 6 | | | | |
| | | FIXTURE AND EQUIPMENT PLAN INTERIOR ELEVATIONS | ADA UPGRADE: SPRECKELS MEMORIAL PARK CORNER OF LLANO AVE. & SECOND ST. 60 LLANO AVE. SPRECKELS, CA 93962 APN # 177-056-001-000 | | |
| | | | CCE CENTRAL COAST ENGINEERS, INC. | | |
| | | | STRUCTURAL DESIGN, INC. SUITE 850D SALINAS CA 93902 P 831.757.5554 F 831.757.2226 | | |
| | | |  | | |
| | | | | REVISIONS | BY DATE |
| | | | | 1 PLAN CHECK 12-22-20 | D.A. |
| | | | | 2 ADDENDUM 2-09-21 | D.A. |